



Red line Version

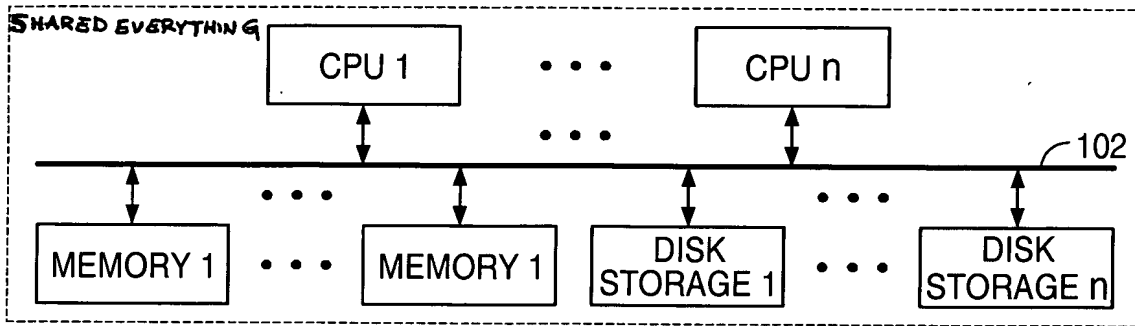


FIG. 1A
(Prior Art)

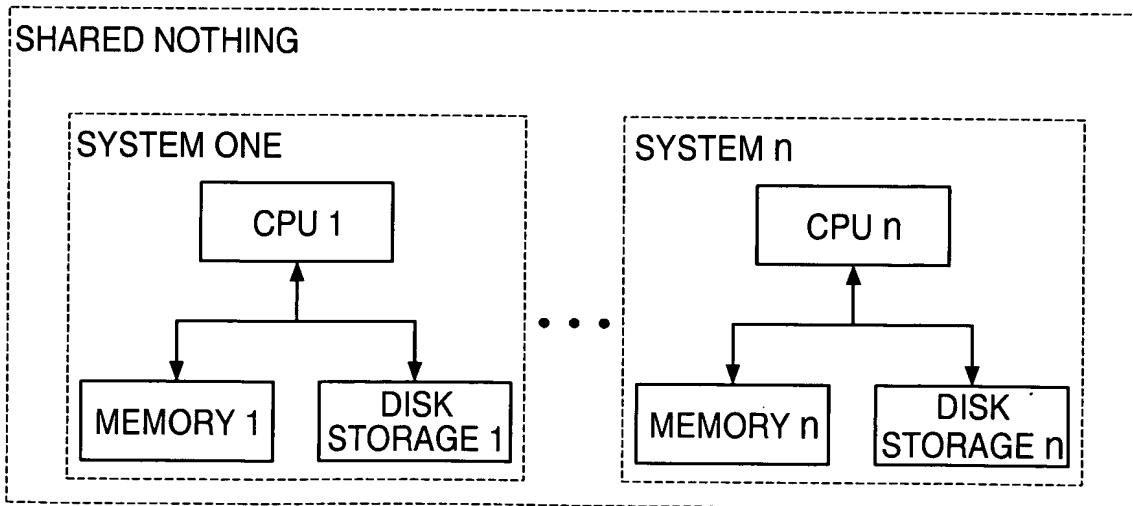


FIG. 1B
(Prior Art)



2/31

RECEIVED

DEC 03 2002

Technology Center 2100

Red line Version

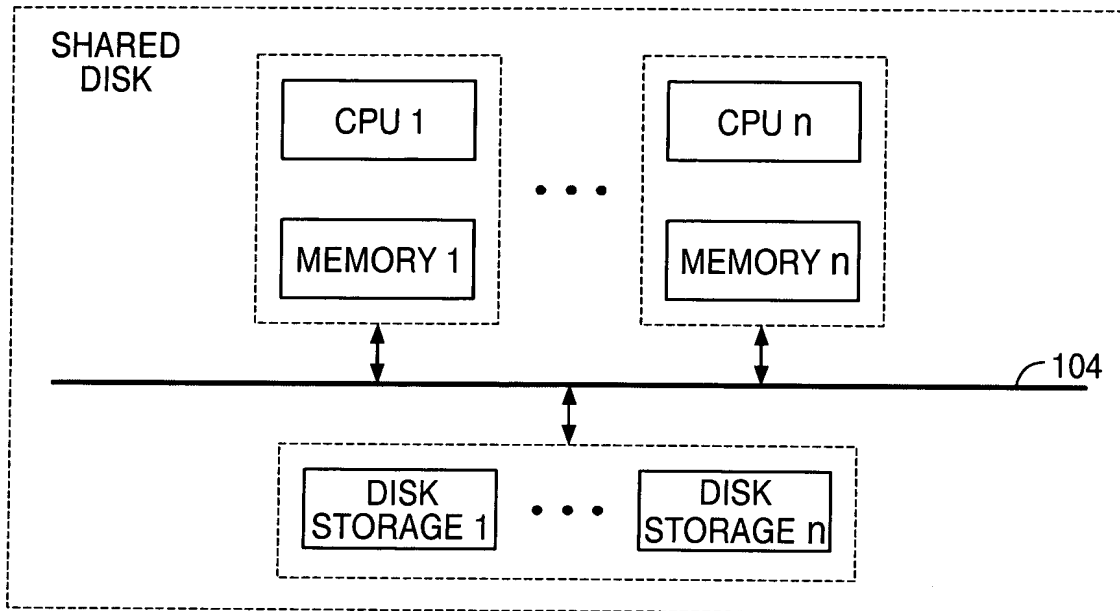


FIG. 1C
(Prior Art)



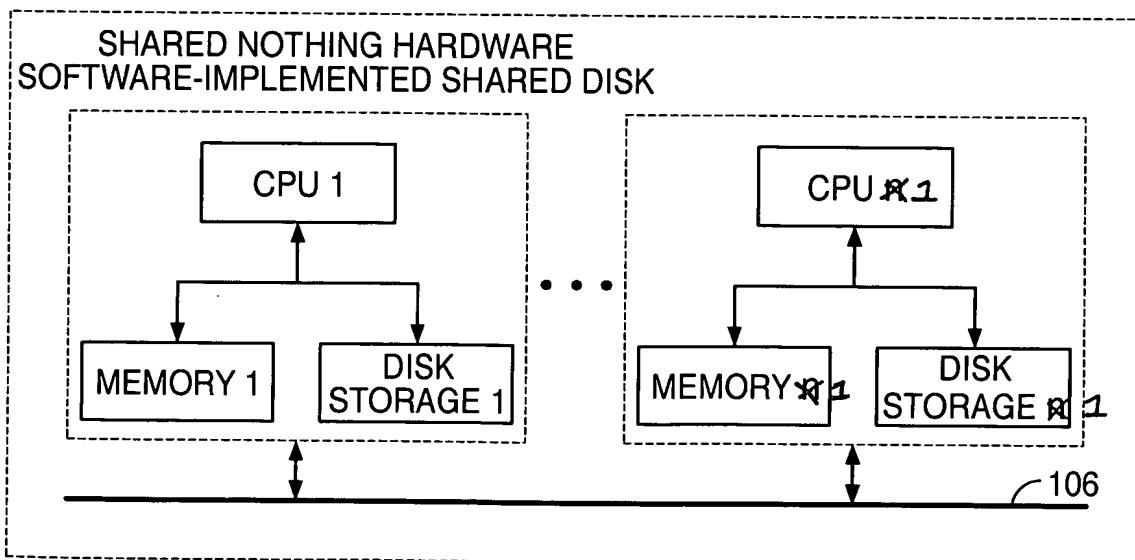


FIG. 1D
(Prior Art)

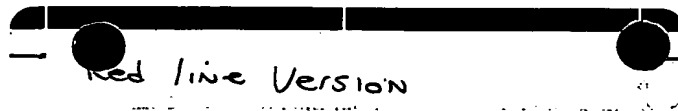

3/31

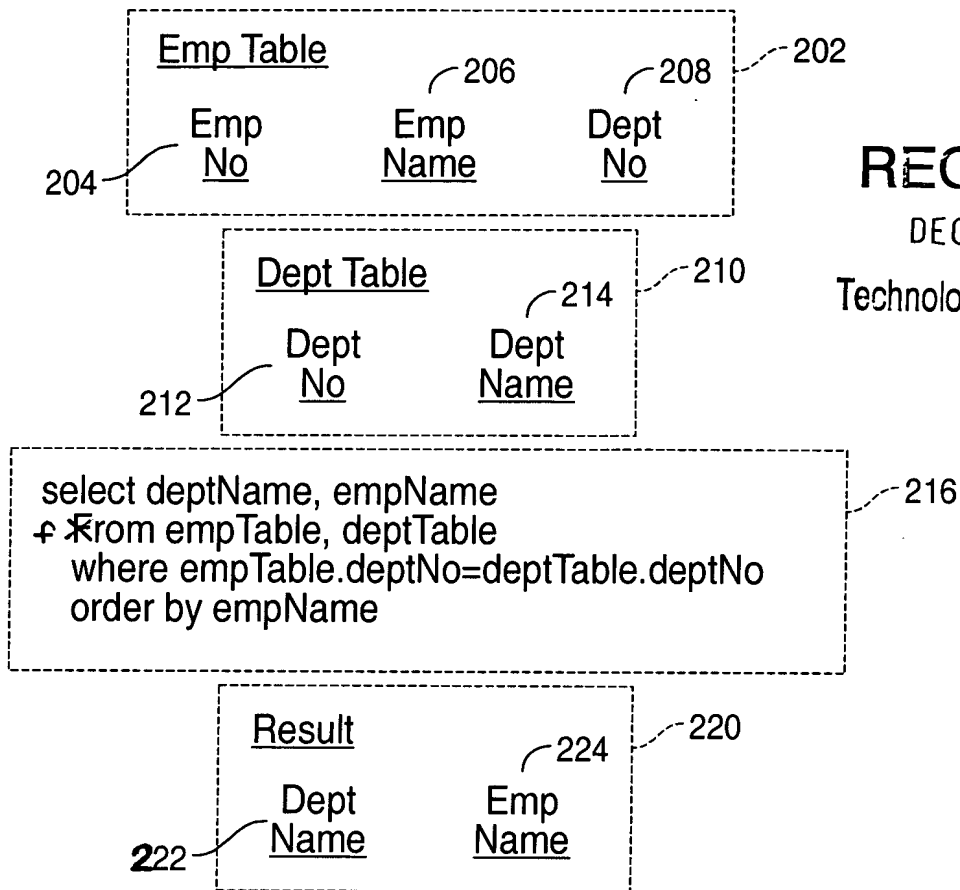

RECEIVED

DEC 03 2002

Technology Center 2100

FIG. 2

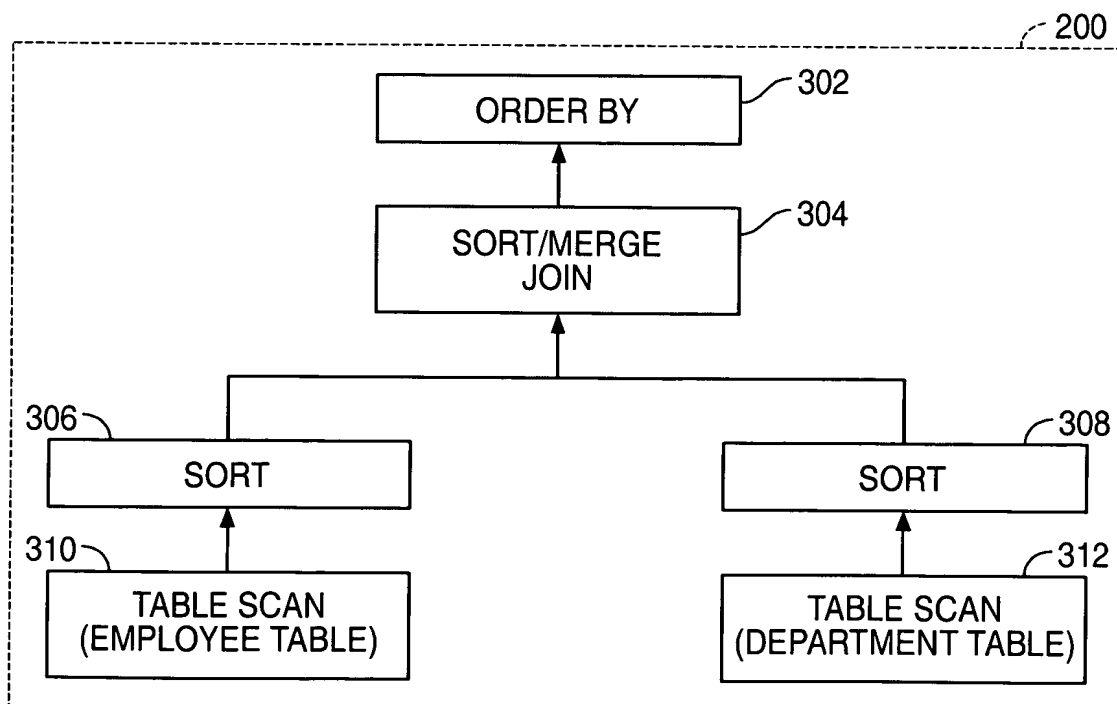


FIG. 3A

16/31

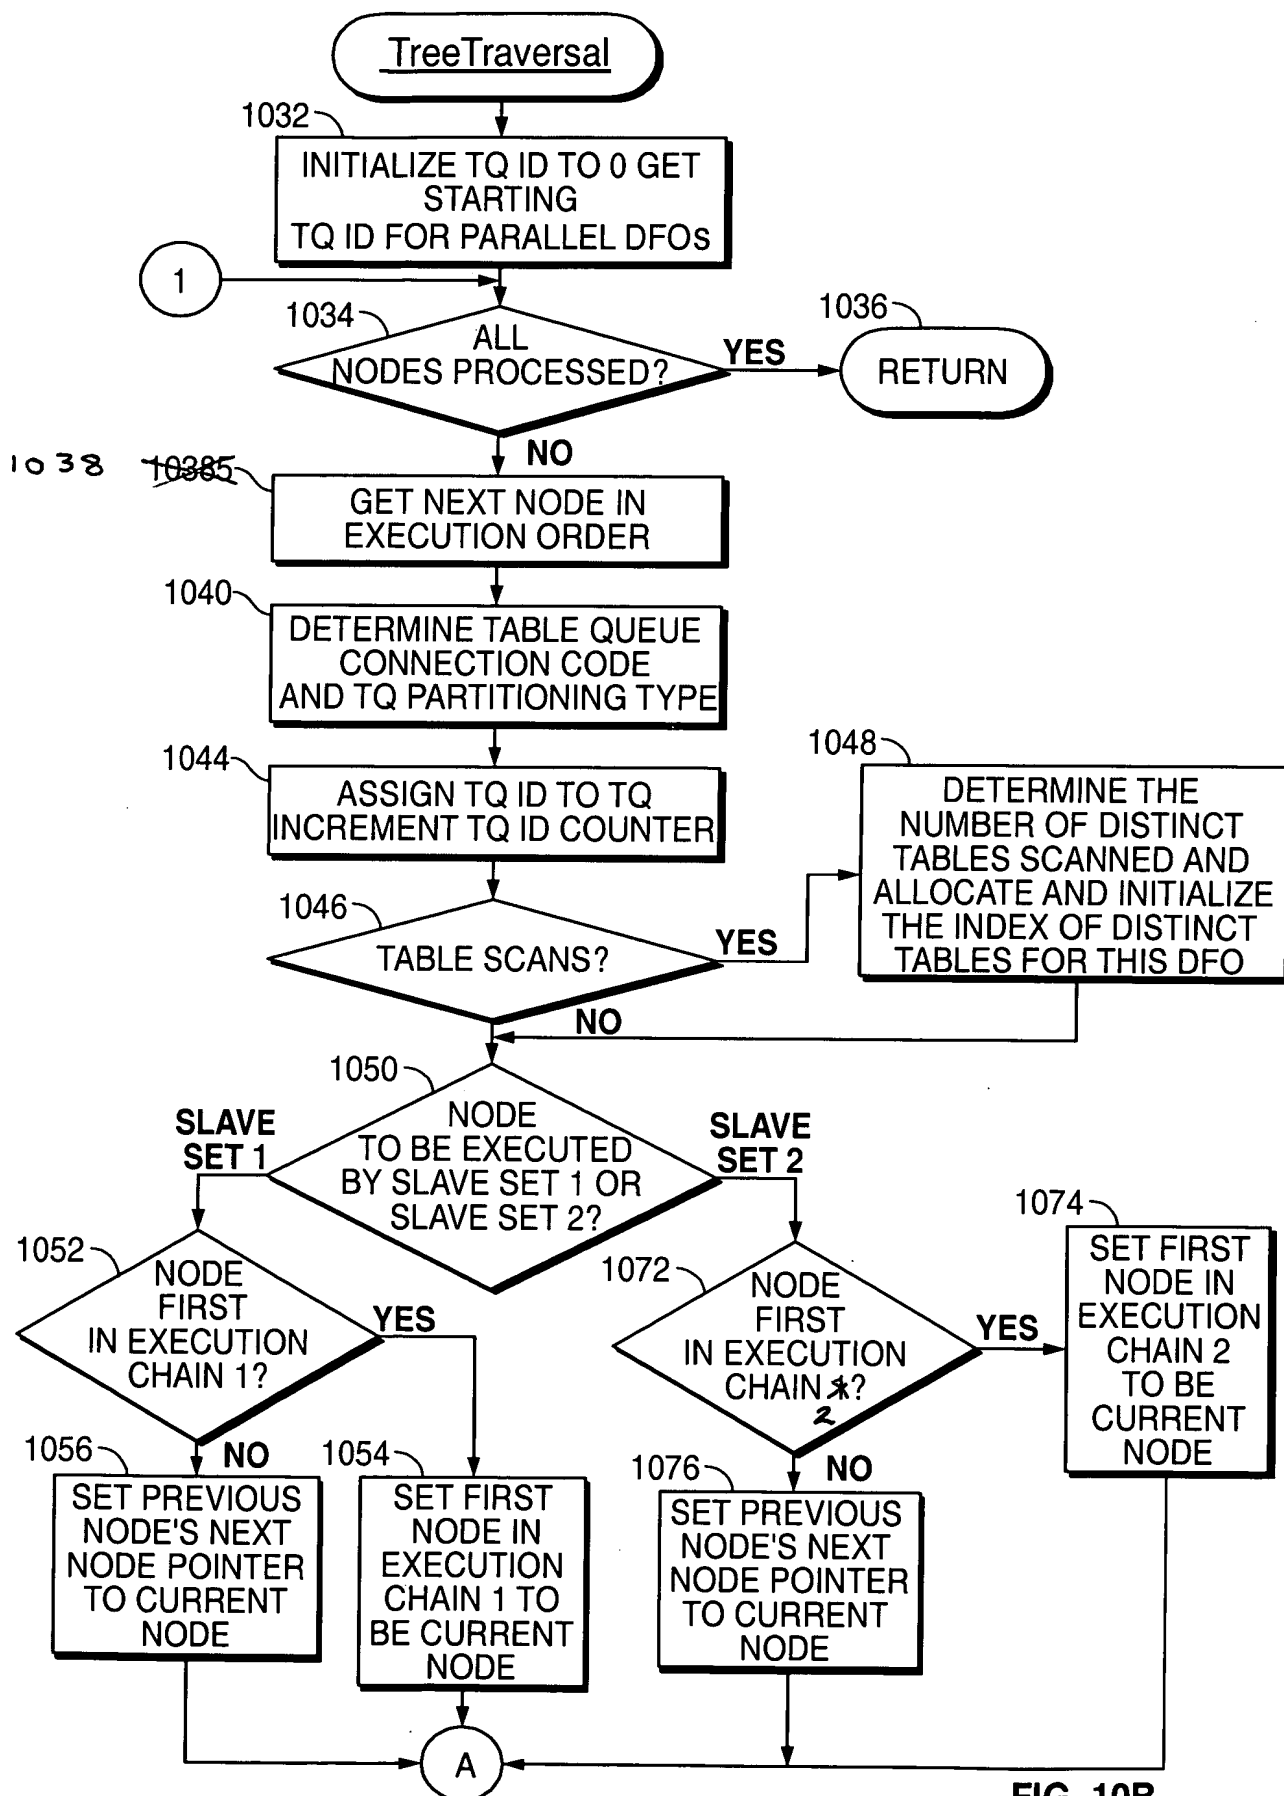


FIG. 10B

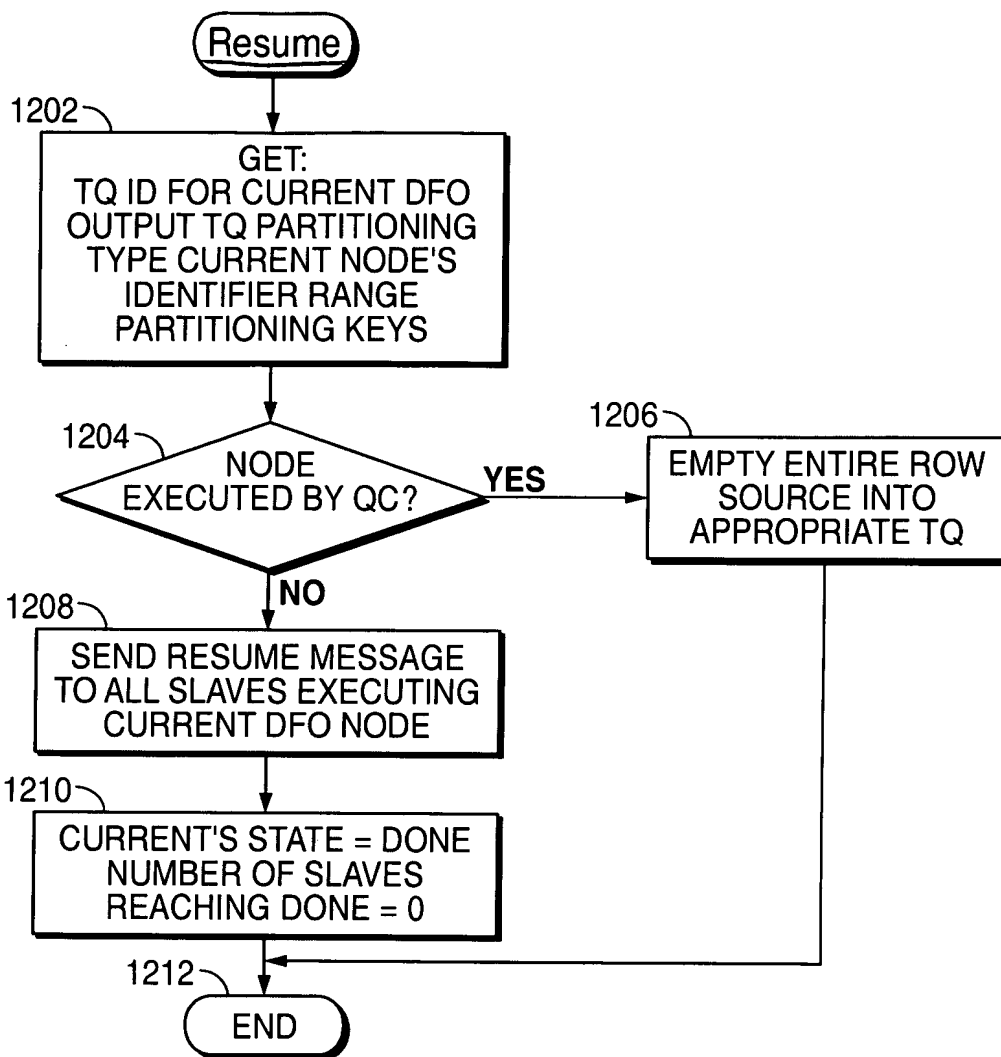


FIG. 12



27/31

Red line Version

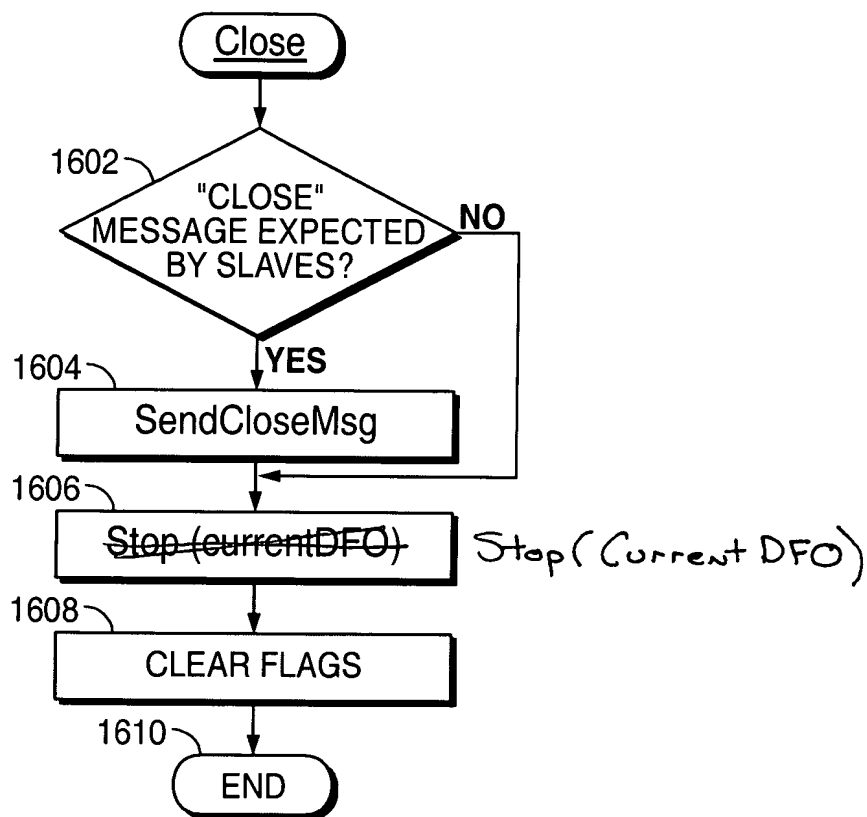


FIG. 16



31/31

Red line Version

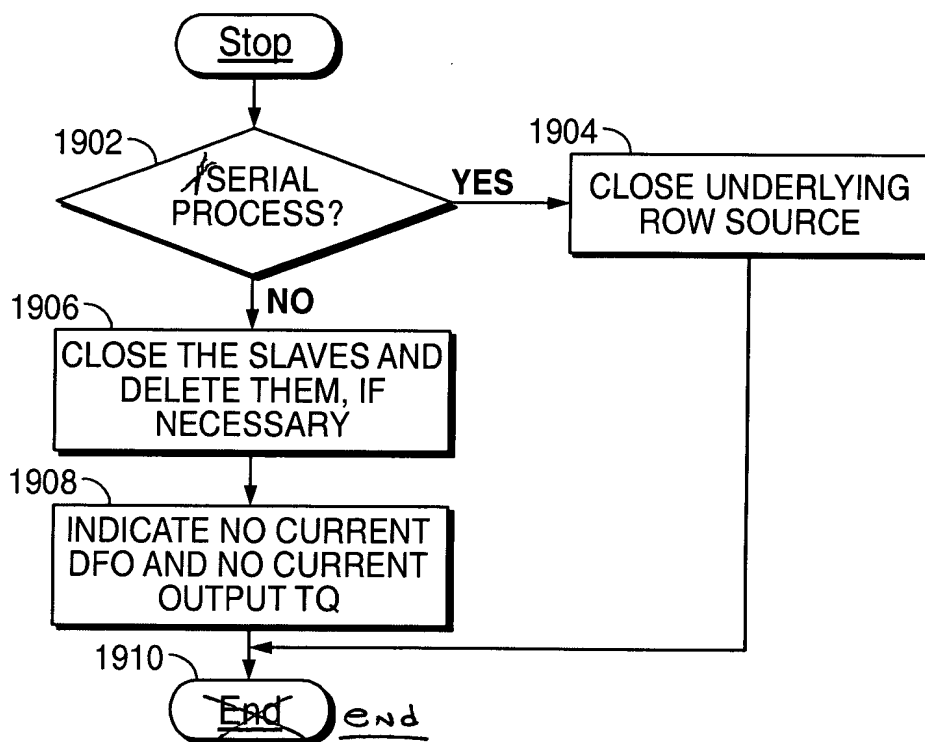


FIG. 19